



NO.	DATE	REVISION
2	2016	BRYANT AVE. SANITARY SEWER (FORCE PUMP)
1	2015	WHITTIER AVE. SANITARY SEWER ASBUILT (1997)

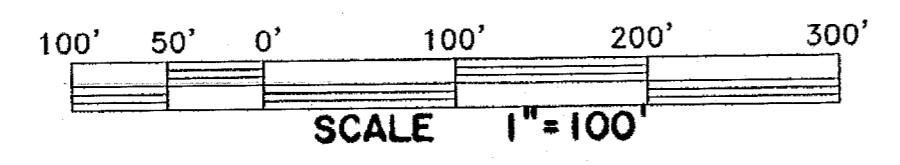

Notes: Revised Sanitary Sewer Map based on original 1958-1961,
 1"=200' scale, 9 sheet linen map set.
 Elevations based on N.G.V.D. 1929 Vertical Datum.

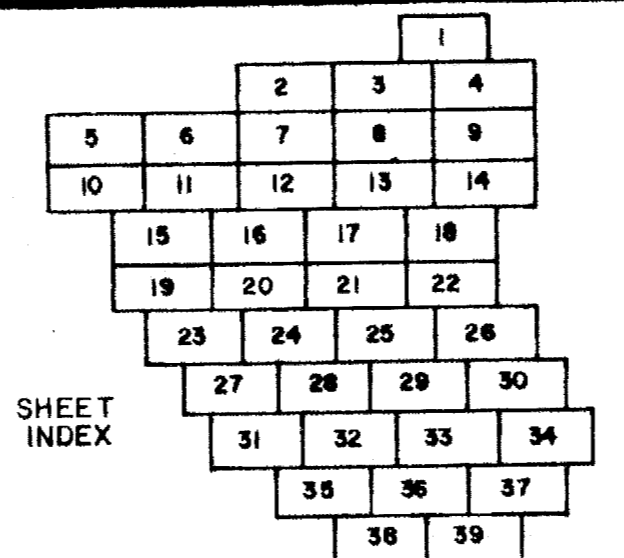

SANITARY SEWER MAP

Prepared By: Westfield Engr. Dept. Date: 9/22/2010

Town Engineer, Kris McAloon, NJPE 39227

TOWN OF WESTFIELD
 DEPT. OF PUBLIC WORKS
 959 NORTH AVE. WEST, WESTFIELD, N.J. 07090
ENGINEERING DEPARTMENT