


-12"	R.C.P.
12"	R.C.P.
15"	R.C.P.
18"	R.C.P.
21"	R.C.P.
24"	R.C.P.
27"	R.C.P.
+27"	R.C.P.

**JAMES D. JOSEPHS N.J.P.E. 17727**  
TOWNSHIP ENGINEER

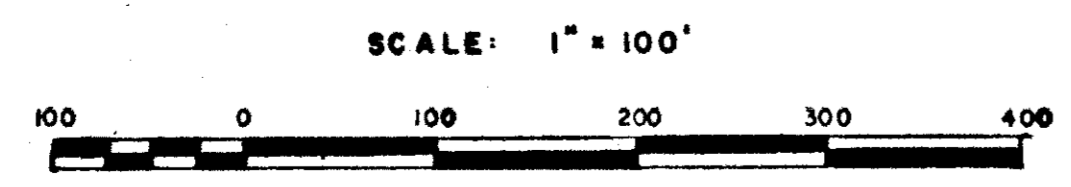

SHEET INDEX

1	2	3	4
5	6	7	8
9	10	11	12
13	14	15	16
17	18	19	20
21	22	23	24
25	26	27	28
29	30	31	32
33	34	35	36
37	38	39	40

NO.	DATE	REVISIONS
3	2015	WHITTIER AVE. STORM SEWER ASBUILT (M)
2	2002	DPW YARD STORM SEWER ASBUILT
1	1993	BIRCH PLACE STORM SEWER ASBUILT

*Richard O. Luster*  
**RICHARD O. LUSTER P.E. & L.S. 9864**

**LUSTER AND GUARRIELLO ASSOC. INC.**  
CONSULTING CIVIL ENGINEERS  
AND  
LAND SURVEYORS  
2279 SOUTH AVE. SCOTCH PLAINS, N.J. 07076

**WESTFIELD DRAINAGE STUDY**  
TOWN OF WESTFIELD  
UNION COUNTY, NEW JERSEY

PROJ. NO. 7614  
**23**  
SHEET NO.